

Date: Monday, 6/5/2006 7:47:58 AM
 User: Kim Johnston

Process Sheet

Customer : CU-DAR001 Dart Helicopters Services Drawing Name : DOUBLER
 Job Number : 27378
 Estimate Number : 11466
 P.O. Number : N/A Part Number : D314092
 This Issue : 6/5/2006 S.O. No. : N/A Drawing Number : D3140 REV D1
 Prsht Rev. : NC Project Number : N/A
 First Issue : N/A Type : SMALL /MED FAB Drawing Revision : D1
 Previous Run : 25733 Material : N/A
 Written By : *Sally Comment Rekr* Due Date : 6/30/2006 Qty: 4 Um: Each
 Checked & Approved By : *06.06.05*
 Comment : Est. A0204.30 New Issue NG
 Est. Rev B New dwg rev. ecn781 06.04.18 EC

Additional Product

Job Number:



Seq. #: Machine Or Operation: Description :

1.0 M2024T3S032 2024-T3 .032 sheet



Comment: Qty.: 0.1549 sf(s)/Unit Total : 0.6195 sf(s)
 2024-T3 .032 sheet
 Matl: 2024-T3 (QQ-A-250/4) .032" thick
 (M2024T3S.032) 5.00" x 4.06" flat pattern ref
 Note grain direction

Batch *M20284* *M* *06.06.07*

2.0 SHEAR SHEAR



Comment: SHEAR
 Cut as per dwg D3140

3.0 HAAS1 HAAS CNC VERTICAL MACHINING #1



Comment: HAAS CNC VERTICAL MACHINING #1
~~Deburr. No sharp edges~~
~~Notch out .75 x .40 corner as per dwg (-91 shown)~~
 Form as per dwg (-91 shown)

Water Jet
Dwg Rev. P1
Pkg Rev. PL *M* *06.06.08 (4)*

4.0 *QC2* INSPECT WORK TO CURRENT STEP



Comment: INSPECT WORK TO CURRENT STEP

M *06.06.08 (4)*

5.0 HAND FINISHING1 HAND FINISHING RESOURCE #1



Comment: HAND FINISHING RESOURCE #1
 Chemical Conversion Coat as per QSI 005 4.1

A. M *06-06-13*

PTD

W/O:		WORK ORDER CHANGES					
DATE	STEP	PROCEDURE CHANGE	By	Date	Qty	Approval Mfg / Design Mgr	Approval QC Inspector

NCR:		WORK ORDER NON-CONFORMANCE (NCR)						
DATE	STEP	Description of NC Section A	Corrective Action Section B			Verification Section C	Approval Design Mgr	Approval QC Inspector
			Initial Design Mgr	Action Description Design Mgr	Sign & Date			

Part No: _____ PAR #: _____ Fault Category: _____ NCR: Yes ☐ No ☒ DQA: DB Date: 06/06/11

NOTE: Date & initial all entries

QA: N/C Closed: _____ Date: _____

Date: Monday, 6/5/2006 7:47:58 AM
User: Kim Johnston

Process Sheet

Customer: CU-DAR001 Dart Helicopters Services

Drawing Name: DOUBLER

Job Number: 27378

Part Number: D314092

Job Number:



Seq. #:

Machine Or Operation:

Description :

6.0

QC3

INSPECT POWDER COAT/CHEMICAL CONVERSION



Comment: INSPECT POWDER COAT/CHEMICAL CONVERSION

C206113106

(4)

7.0

PACKAGING 1

PACKAGING RESOURCE #1



Comment: PACKAGING RESOURCE #1

Identify and Stock

Location:

C206113106 (4)

8.0

DC

DOCUMENT CONTROL



Comment: DOCUMENT CONTROL

Inspection Level 21

DB 06/06/14 (4)

Job Completion



U 06.06.07

4.2 Small fab
form is per Day D3140

SB

06/06/13

(4)

4.3 QCS 06.06.13 (4)

BL

W/O:		WORK ORDER CHANGES					
DATE	STEP	PROCEDURE CHANGE	By	Date	Qty	Approval Mfg / Design Mgr	Approval QC Inspector

NCR:		WORK ORDER NON-CONFORMANCE (NCR)						
DATE	STEP	Description of NC Section A	Corrective Action Section B			Verification Section C	Approval Design Mgr	Approval QC Inspector
			Initial Design Mgr	Action Description Design Mgr	Sign & Date			

Part No: _____ PAR #: _____ Fault Category: _____ NCR: Yes No DQA: _____ Date: _____

NOTE: Date & initial all entries

QA: N/C Closed: _____ Date: _____



DESIGN DS	DRAWN BY RF	DART AEROSPACE LTD HAWKESBURY, ONTARIO, CANADA	
CHECKED [Signature]	APPROVED [Signature]	DRAWING NO. D3140	REV. D SHEET 1 OF 7
DATE 05.11.23		TITLE DOOR	SCALE NTS
A	02.04.18	NEW ISSUE	
B	03.01.23	REMOVE -65/-81/-83; ADD -301/-303	
C	04.11.08	CHANGE DELASTEK SPEC. TEC-77; ADD PART MARKING; ADD NOTES 11, 12, 13; CHANGE ANGLE -95/-97/-98 TO 106°	
D	05.11.23	ADD -103/-104/-105/-106; REMOVE -67	
DI	06.03.31	1.75 WAS 1.88; 4.75 WAS 4.13	

RELEASED
05.12.01 [Signature]

QTY -05	QTY -06	QTY -07	QTY -08	QTY -09	QTY -10	PART NUMBER	DESCRIPTION
X						D3140-05	DOOR
	X					D3140-06	DOOR
		X				D3140-07	DOOR
			X			D3140-08	DOOR
		1		X		D3140-09	DOUBLER ASSEMBLY
			1		X	D3140-10	DOUBLER ASSEMBLY
3	3					D3140-57	PAD
1	1					D3140-59	PAD
2	2					D3140-61	PAD
2	2					D3140-63	PAD
		1	1			D3140-69	PAD
		1	1			D3140-71	PAD
		1	1			D3140-73	PAD
		1	1			D3140-75	PAD
		1	1			D3140-77	PAD
		1	1			D3140-79	PAD
				1	1	D3140-85	ANGLE
1	1					D3140-87	DOUBLER
				1	1	D3140-89	DOUBLER
		1				D3140-91	DOUBLER
			1			D3140-92	DOUBLER
3	3					D3140-95	DOUBLER
1						D3140-97	DOUBLER
	1					D3140-98	DOUBLER
		1	1			D3140-99	DOUBLER
		2	2			D3140-101	DOUBLER
		1				D3140-103	DOUBLER
			1			D3140-104	DOUBLER
		1				D3140-105	DOUBLER
			1			D3140-106	DOUBLER
1	1					D3140-241	DOUBLER
1		1				D3140-301	DOUBLER
	1		1			D3140-303	DOUBLER
				5	5	MS20426AD3-4	RIVET

SHOP COPY
RETURN TO
ENGINEERING
UNCONTROLLED COPY
SUBJECT TO AMENDMENT
WITHOUT NOTICE
WORK ORDER
NO. 27378



Copyright © 2002 by DART AEROSPACE LTD

THIS DOCUMENT IS PRIVATE AND CONFIDENTIAL AND IS SUPPLIED ON THE EXPRESS CONDITION THAT IT IS NOT TO BE USED FOR ANY PURPOSE OR COPIED OR COMMUNICATED TO ANY OTHER PERSON WITHOUT WRITTEN PERMISSION FROM DART AEROSPACE LTD.



DESIGN DS	DRAWN BY RF	DART AEROSPACE LTD HAWKESBURY, ONTARIO, CANADA	
CHECKED <i>[Signature]</i>	APPROVED <i>[Signature]</i>	DRAWING NO. D3140	REV. 0 SHEET 2 OF 7
DATE 05.11.23		TITLE DOOR	SCALE NTS

1

COMPOSITE LAYUP & BONDING I.A.W. DELASTEK PROCESS SPEC. TEC-77
MATERIAL STORAGE & HANDLING TO BE I.A.W. DART QSI 006
MAIN LAYUP USES FIBERCOTE E-761/7781 EPOXY FIBERGLASS.
FILL WITH EPOCAST 87269 OR MAGNOBOND 77 A & B AND MA560 FOAM/ NB-51/30 FOAM

2

FINISH: DUPONT HIGHBUILD GREY PRIMER 1144-S

3

MAKE PARTS IN ACCORDANCE WITH THE FOLLOWING TOOLS/MOLDS:

PART	TOOL
D3140-05	B30-23000-01T
D3140-06	B30-23000-02T
D3140-07	B30-23000-03T
D3140-08	B30-23000-04T
D3140-57	B30-23000-57T
D3140-61	B30-23000-61T
D3140-63	B30-23000-63T
D3140-69	B30-23000-69T
D3140-71	B30-23000-71T
D3140-73	B30-23000-73T
D3140-75	B30-23000-75T
D3140-77	B30-23000-77T
D3140-79	B30-23000-79T
D3140-89	D3140-89T1
D3140-301	D3140-301T1
D3140-303	D3140-303T1

RELEASED
05.12.01

4

MATERIAL: 2024-T3 (QQ-A-250/4) 0.032 THICK (M2024T3S.032)
FINISH: CHEMICAL CONVERSION COAT PER DART QSI 005 4.1

5

MATERIAL: 2024-T3 (QQ-A-250/4) 0.020 THICK (M2024T3S.020)
FINISH: CHEMICAL CONVERSION COAT PER DART QSI 005 4.1

6

MATERIAL: 5052-H32/H34 (QQ-A-250/8) 0.040 THICK (M5052H32S.040)
FINISH: CHEMICAL CONVERSION COAT PER DART QSI 005 4.1

7

MATERIAL: POLIMEX TR75 1" THICK 4.5 LB KLEGECELL

8

ALL DIMENSIONS IN INCHES

9

TOLERANCES ARE PER DART QSI 018 UNLESS OTHERWISE NOTED

10

MATERIAL: 6061-T6 (QQ-A-250/11) 0.063 THICK (M6061-T6S.063)
FINISH: CHEMICAL CONVERSION COAT PER DART QSI 005 4.1

11

DOUBLER TO SIT ON TOP OF FOAM AT THIS LOCATION

12

DOUBLER TO BE RECESSED FLUSH INTO FOAM AT THIS LOCATION


13

RUBBER STAMP WITH DART P/N D3140-05/-06/-07/-08 USING MIL-STD-130

SHOP COPY
RETURN TO
ENGINEERING
UNCONTROLLED COPY
SUBJECT TO AMENDMENT
WITHOUT NOTICE
WORK ORDER
NO. 27378


Copyright © 2002 by DART AEROSPACE LTD

THIS DOCUMENT IS PRIVATE AND CONFIDENTIAL AND IS SUPPLIED ON THE EXPRESS CONDITION THAT IT IS NOT TO BE USED FOR ANY PURPOSE OR COPIED OR COMMUNICATED TO ANY OTHER PERSON WITHOUT WRITTEN PERMISSION FROM DART AEROSPACE LTD.

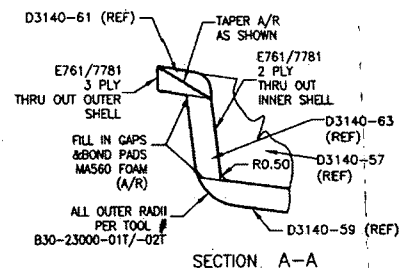

SECTION. A-A

RELEASED
05-12-01

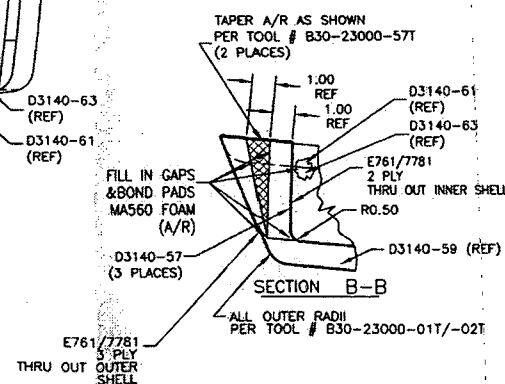


SECTION B-E

Three triangles are shown, labeled 1, 2, and 3 from left to right. Each triangle has a small circle above its top vertex.

DESIGN DS	DRAWN BY RF	DART	DART AEROSPACE LTD. MARKHAM, ONTARIO, CANADA
<i>RF</i>	APPROVED <i>RF</i>	DRAWING NO. D3140	REV. SHEET 3 OF
DATE 05.11.23	TITLE DOOR		SCALE NT


SHOP COPY
RETURN TO
ENGINEERING
UNCONTROLLED COPY
SUBJECT TO AMENDMENT
WITHOUT NOTICE
WORK ORDER
NO. 27378

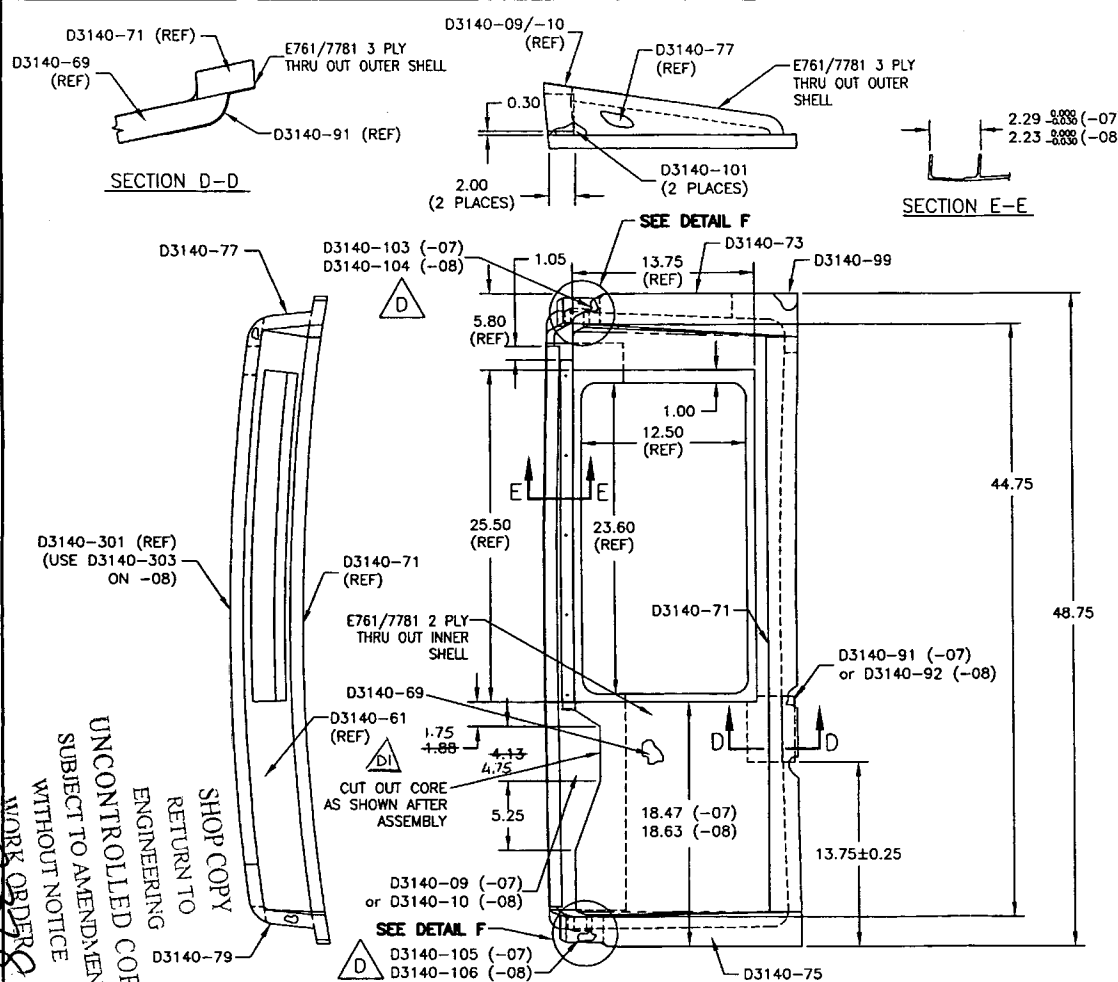

SECTION E-E


DETAIL F
(TYPICAL 2 PLACES)

D3140-07 DOOR (SHOWN, REPLACES PREMIER P/N B30-23000-07)
D3140-08 (OPPOSITE, REPLACES PREMIER P/N B30-23000-08)
 (WINDOW TO BE LOCATED BY TOOL B30-23000-03T/-04T)

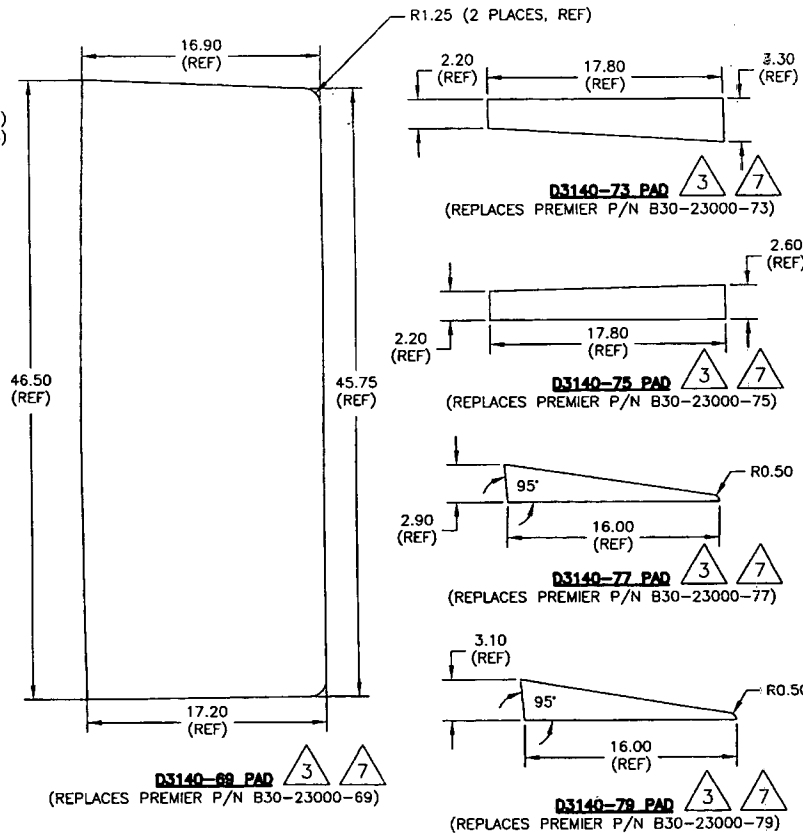

RELEASED

NO. 29378
 WORK ORDER
 SUBJECT TO AMENDMENT
 WITHOUT NOTICE
 UNCONTROLLED COPY
 RETURN TO
 ENGINEERING
 SHOP COPY

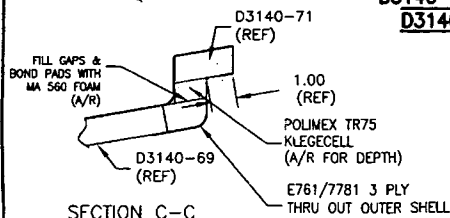


SECTION C-C


COPYRIGHT © 2002 BY DART AEROSPACE LTD.

THIS DOCUMENT IS PRIVATE AND CONFIDENTIAL AND IS SUPPLIED ON THE EXPRESS CONDITION THAT IT IS NOT TO BE USED FOR ANY PURPOSE OR COPIED OR COMMUNICATED TO ANY OTHER PERSON WITHOUT WRITTEN PERMISSION FROM DART AEROSPACE LTD.


DESIGN DS	DRAWN BY RF	DART	DART AEROSPACE LTD. HARRISBURG, ONTARIO, CANADA
CHECKED [Signature]	APPROVED [Signature]	DRAWING NO. D3140	REV. 0
DATE 05.11.23	TITLE DOOR	SHEET 4 OF 7	SCALE NTS

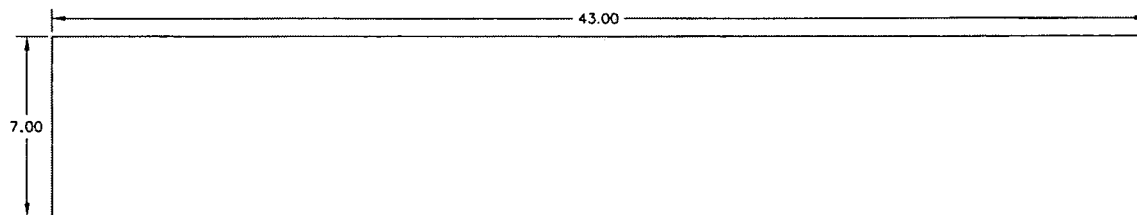

D3140-87 DOUBLER $\triangle 4$
(REPLACES PREMIER P/N B30-23000-87)

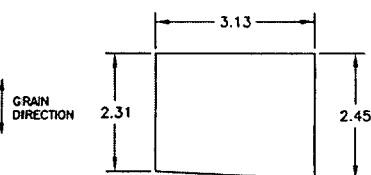


D3140-105F FLAT PATTERN
(USED TO MAKE D3140-105/-106 BRACKETS)

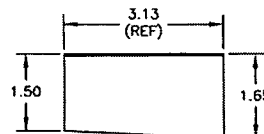


D3140-105 DOUBLER
D3140-106 OPPOSITE


$\triangle 4$ $\triangle D$

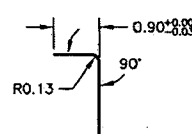

GRAIN DIRECTION

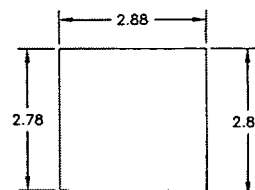


D3140-103F FLAT PATTERN
(USED TO MAKE D3140-103/-104 BRACKETS)

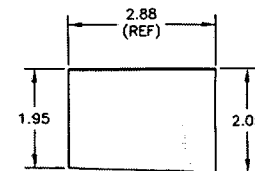


D3140-103 DOUBLER
D3140-104 OPPOSITE


$\triangle 4$ $\triangle D$

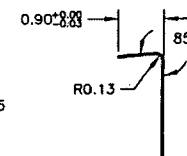


D3159-3F FLAT PATTERN
(USED TO MAKE D3159-3/-4 BRACKETS)

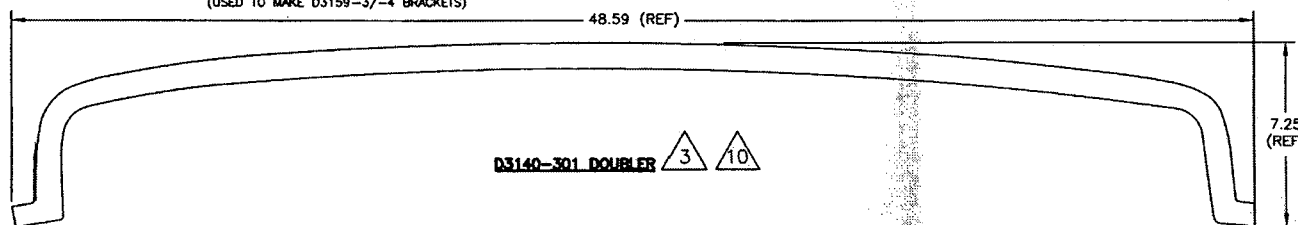

D3140-301 DOUBLER $\triangle 3$ $\triangle 10$

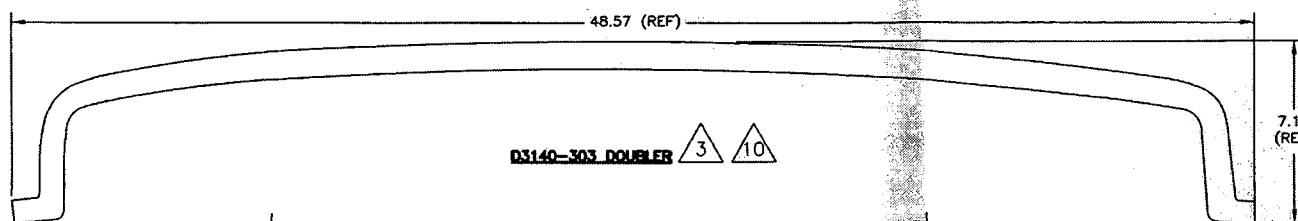

D3140-303 DOUBLER $\triangle 3$ $\triangle 10$

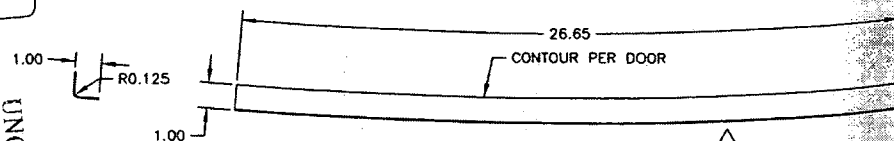

D3140-85 ANGLE $\triangle 6$
FLAT PATTERN: 26.65" x 1.90"
(REPLACES PREMIER P/N B30-23000-85)


RELEASED



COPYRIGHT © 2002 BY DART AEROSPACE LTD.


THIS DOCUMENT IS PRIVATE AND CONFIDENTIAL AND IS SUPPLIED ON THE EXPRESS CONDITION THAT IT IS NOT TO BE USED FOR ANY PURPOSE OR COPIED OR COMMUNICATED TO ANY OTHER PERSON WITHOUT WRITTEN PERMISSION FROM DART AEROSPACE LTD.



DESIGN DS	DRAWN BY RF	DART	DART AEROSPACE LTD. THUNDERBOLT, ONTARIO, CANADA
CHECKED [Signature]	APPROVED [Signature]	DRAWING NO. D3140	REV. D SHEET 6 OF 7
DATE 05.11.23	TITLE DOOR	SCALE NTS	

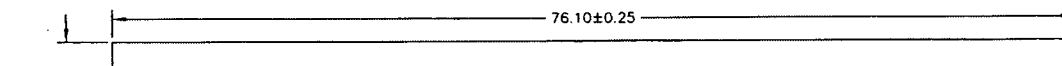
NO. 27378
WORK ORDER
WITHOUT NOTICE
SUBJECT TO AMENDMENT
UNCONTROLLED COPY
ENGINEERING
RETURN TO
SHOW COPY




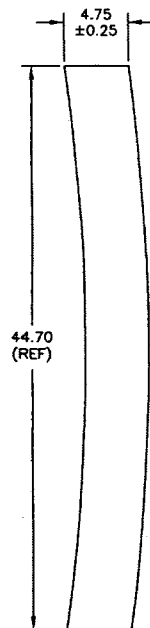
D3140-61 PAD  
(REPLACES PREMIER P/N B30-23000-61)

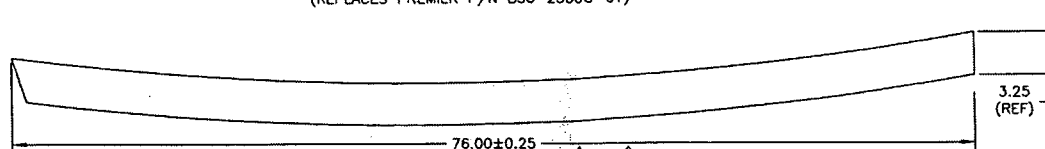


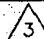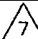
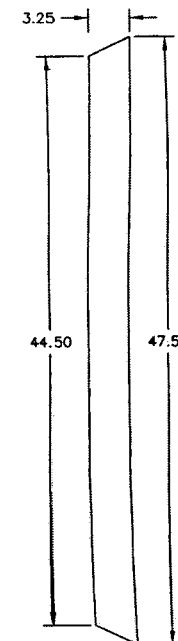
D3140-63 PAD  
(REPLACES PREMIER P/N B30-23000-63)

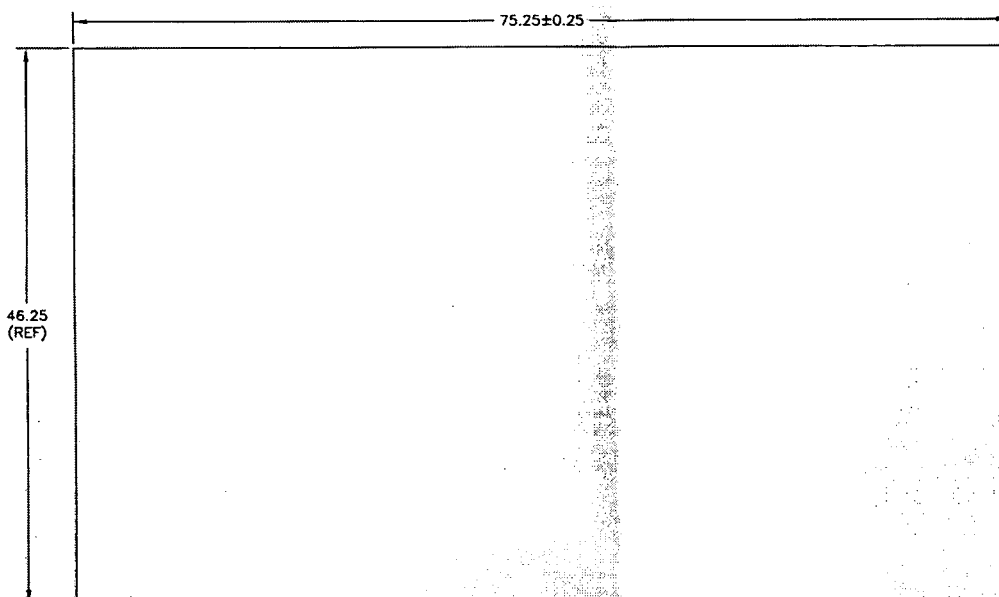


D3140-59 PAD 
(REPLACES PREMIER P/N B30-23000-59)



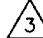

D3140-57 PAD
(REPLACES PREMIER P/N B30-23000-57)
 

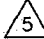

D3140-241 DOUBLER 
(REPLACES PREMIER P/N B30-23000-241)

R1.00
(2 PLACES, REF)

RELEASED
05.11.23

COPYRIGHT © 2002 BY DART AEROSPACE LTD.		DESIGN DS	DRAWN BY RF	DART DART AEROSPACE LTD. WARRICKBURGH, ONTARIO, CANADA
THIS DOCUMENT IS PRIVATE AND CONFIDENTIAL AND IS SUPPLIED ON THE EXPRESS CONDITION THAT IT IS NOT TO BE USED FOR ANY PURPOSE OR COPIED OR COMMUNICATED TO ANY OTHER PERSON WITHOUT WRITTEN PERMISSION FROM DART AEROSPACE LTD.		CHECKED 	APPROVED 	REV. 0
DATE 05.11.23		DRAWING NO. 03140		SHEET 7 OF 7
		TITLE DOOR		SCALE NTS

NO. **29378**
WORK ORDER
SHOP COPY
RETURN TO
ENGINEERING
UNCONTROLLED COPY
SUBJECT TO AMENDMENT
WITHOUT NOTICE

